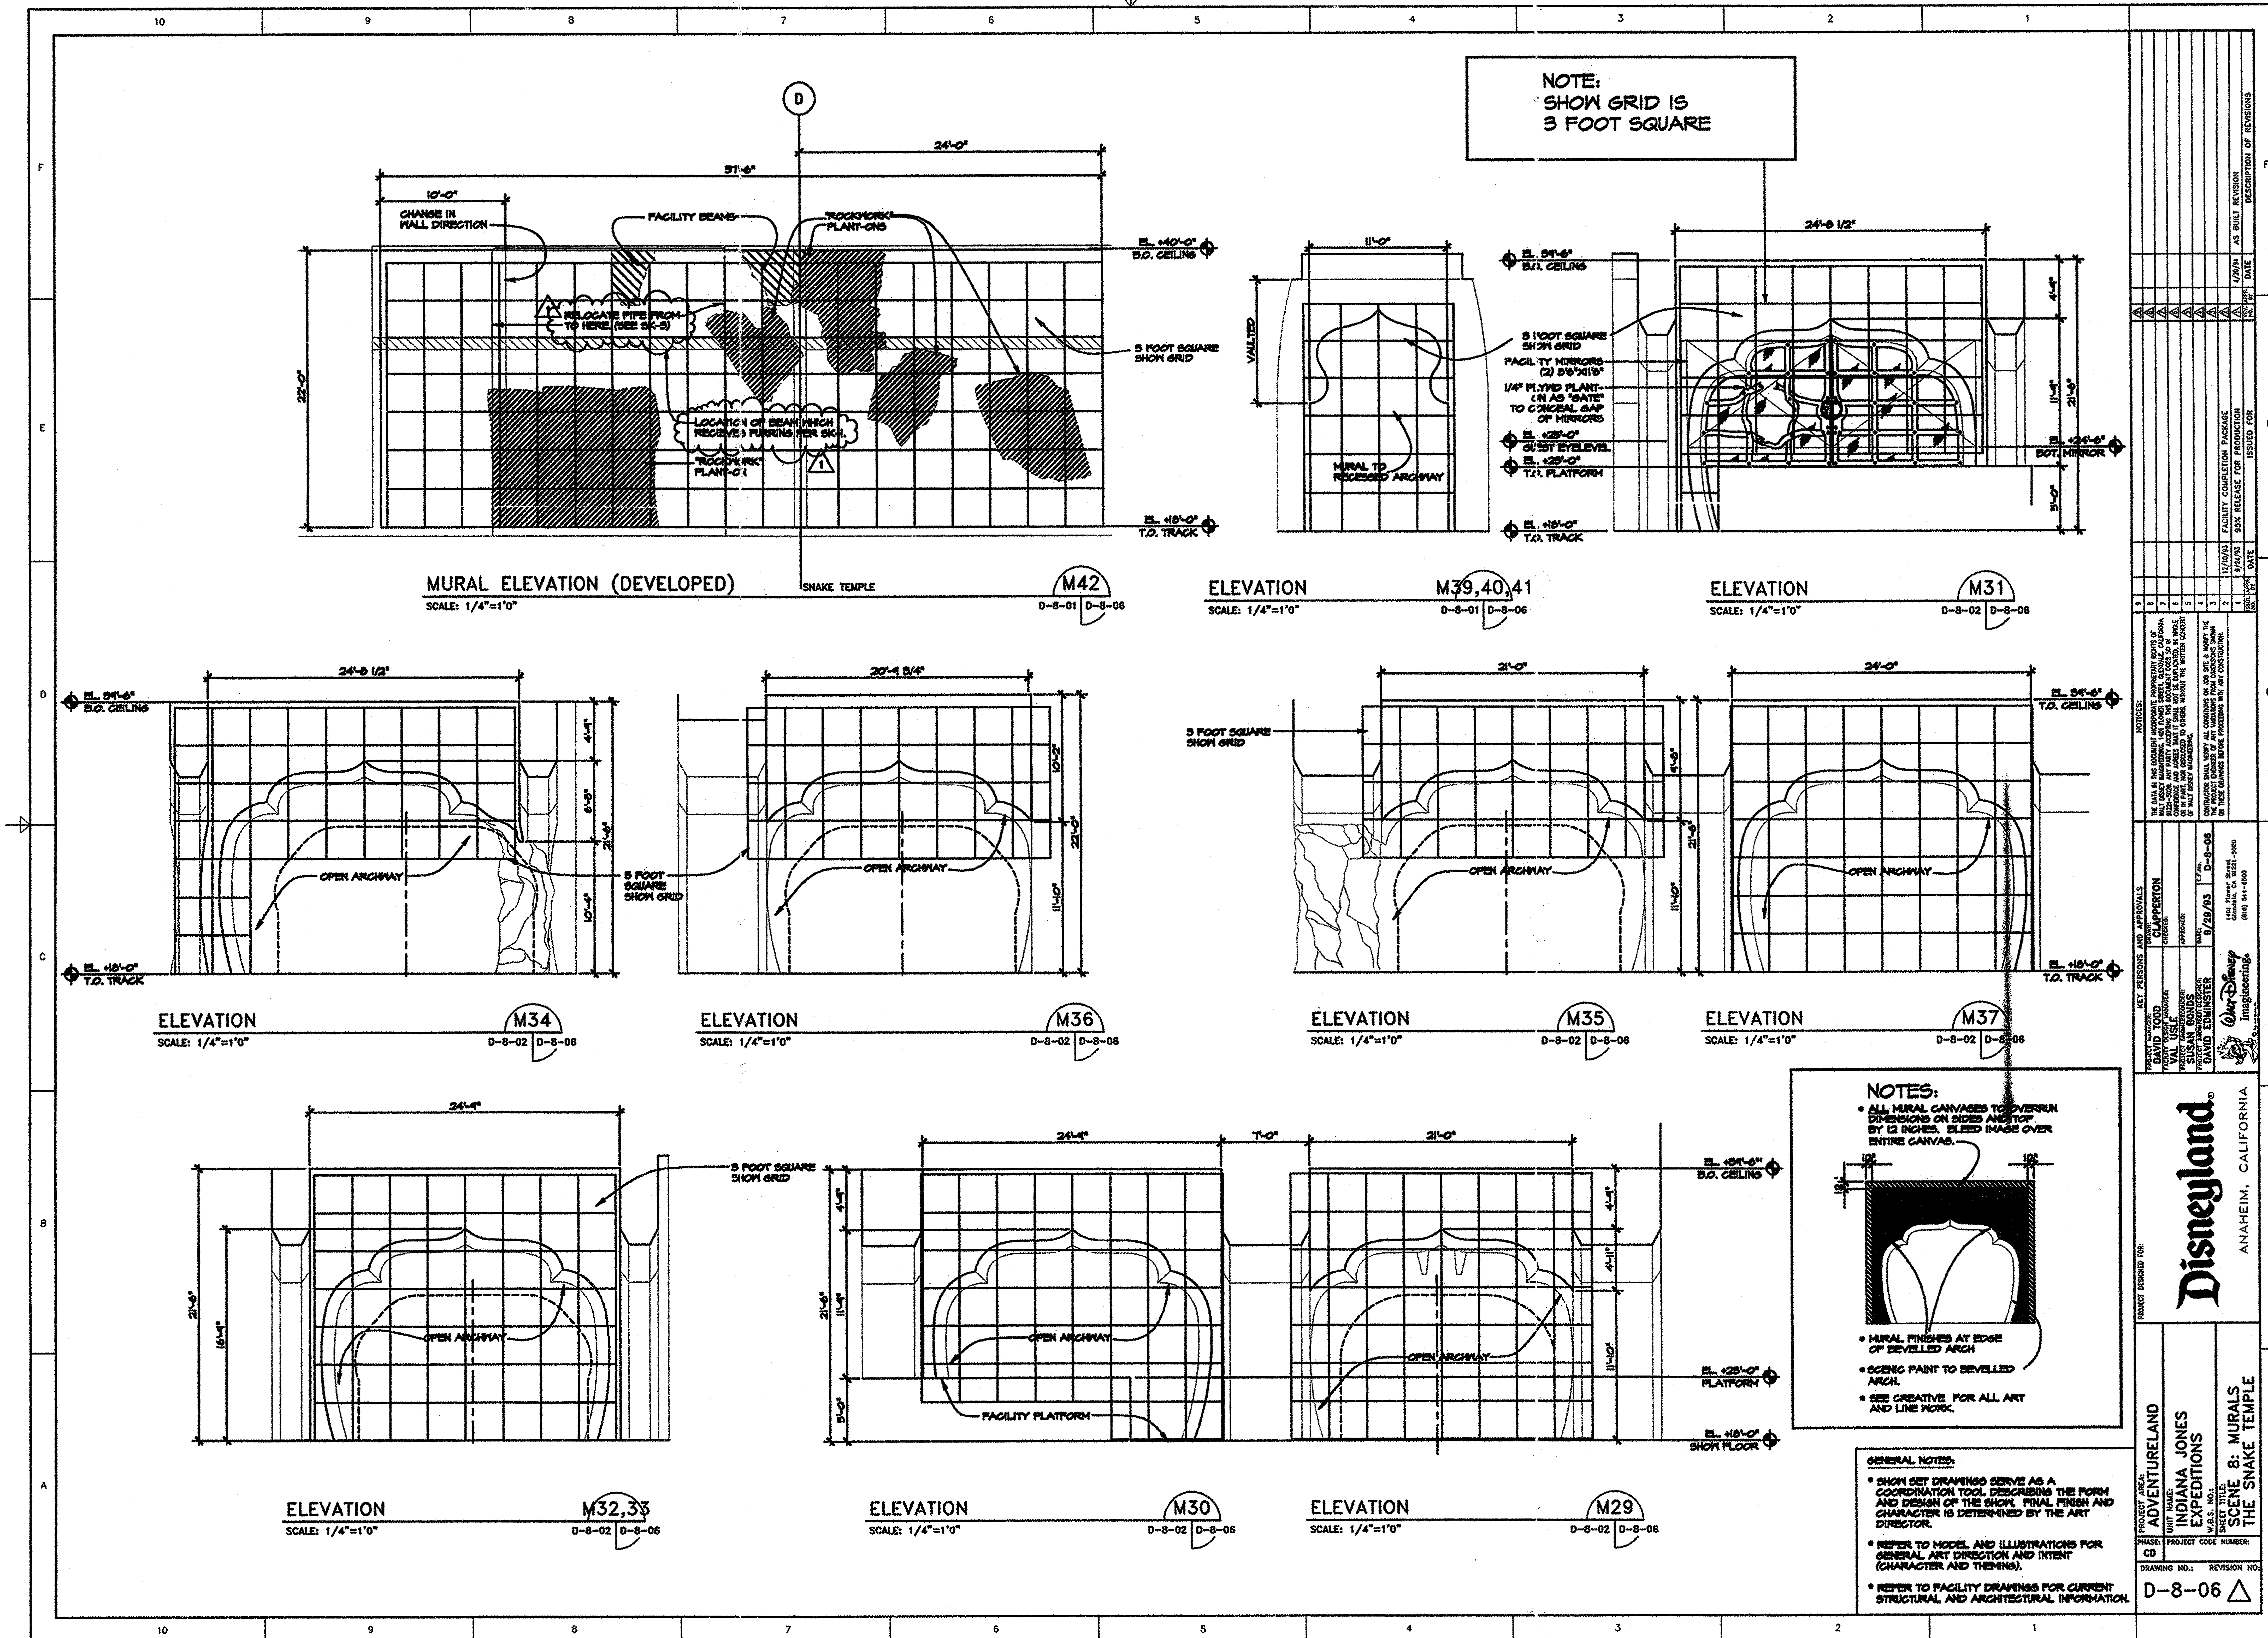

NOTE:
SHOW GRID IS
3 FOOT SQUARE
MURAL ELEVATION (DEVELOPED)
SCALE: 1/4"=1'0"
M42
SNAKE TEMPLE
CHANGE IN WALL DIRECTION
FACILITY BEAMS
"ROCKWORK" PLANT-ONS
RELOCATE PIPE FROM - TO HERE (SEE SK-3)
3 FOOT SQUARE SHOW GRID
EL. +40'-0" B.O. CEILING
EL. +18'-0" T.O. TRACK
ELEVATION
M39,40,41
SCALE: 1/4"=1'0"
VAULTED
MURAL TO RECESSED ARCHWAY
EL. 34'-6" B.O. CEILING
3 FOOT SQUARE SHOW GRID
EL. +25'-0" GUEST EYELEVEL
EL. +25'-0" T.O. PLATFORM
ELEVATION
M31
SCALE: 1/4"=1'0"
EL. +24'-6" BOT. MIRROR
ELEVATION
M34
SCALE: 1/4"=1'0"
OPEN ARCHWAY
3 FOOT SQUARE SHOW GRID
ELEVATION
M36
SCALE: 1/4"=1'0"
ELEVATION
M35
SCALE: 1/4"=1'0"
ELEVATION
M37
SCALE: 1/4"=1'0"
EL. 34'-6" T.O. CEILING
EL. +18'-0" T.O. TRACK
ELEVATION
M32,33
SCALE: 1/4"=1'0"
ELEVATION
M30
SCALE: 1/4"=1'0"
FACILITY PLATFORM
ELEVATION
M29
SCALE: 1/4"=1'0"
EL. +18'-0" SHOW FLOOR
NOTES:
• ALL MURAL CANVASES TO OVERRUN DIMENSIONS ON SIDES AND TOP BY 12 INCHES. BLEED IMAGE OVER ENTIRE CANVAS.
• MURAL FINISHES AT EDGE OF BEVELLED ARCH
• SCENIC PAINT TO BEVELLED ARCH.
• SEE CREATIVE FOR ALL ART AND LINE WORK.
GENERAL NOTES:
• SHOW SET DRAWINGS SERVE AS A COORDINATION TOOL DESCRIBING THE FORM AND DESIGN OF THE SHOW. FINAL FINISH AND CHARACTER IS DETERMINED BY THE ART DIRECTOR.
• REFER TO MODEL AND ILLUSTRATIONS FOR GENERAL ART DIRECTION AND INTENT (CHARACTER AND THEMING).
• REFER TO FACILITY DRAWINGS FOR CURRENT STRUCTURAL AND ARCHITECTURAL INFORMATION.
AS BUILT REVISION
FACILITY COMPLETION PACKAGE
95% RELEASE FOR PRODUCTION
NOTICES:
THE DATA IN THIS DOCUMENT INCORPORATE PROPRIETARY RIGHTS OF WALT DISNEY IMAGINEERING, 1401 FLOWER STREET, GLENDALE, CALIFORNIA 91221-5020. ANY PARTY ACCEPTING THIS DOCUMENT DOES SO IN CONFIDENCE AND AGREES THAT IT SHALL NOT BE DUPLICATED, IN WHOLE OR IN PART, NOR DISCLOSED TO OTHERS, WITHOUT THE WRITTEN CONSENT OF WALT DISNEY IMAGINEERING.
CONTRACTOR SHALL VERIFY ALL CONDITIONS ON JOB SITE & NOTIFY THE PROJECT ENGINEER OF ANY VARIATIONS FROM DIMENSIONS SHOWN ON THESE DRAWINGS BEFORE PROCEEDING WITH ANY CONSTRUCTION.
KEY PERSONS AND APPROVALS
PROJECT MANAGER: DAVID TODD
DRAWN: CLAPPERTON
FACILITY DESIGN MANAGER: VAL USLE
PROJECT SHOW PRODUCER: SUSAN BONDS
PROJECT SHOW DESIGNER: DAVID EDMINSTER
DATE: 9/29/93
D-8-06
Walt Disney Imagineering
1401 Flower Street Glendale, CA 91221-5020
(818) 544-6500
PROJECT DESIGNED FOR:
Disneyland
ANAHEIM, CALIFORNIA
PROJECT AREA: ADVENTURELAND
UNIT NAME: INDIANA JONES EXPEDITIONS
SHEET TITLE: SCENE 8: MURALS THE SNAKE TEMPLE
PHASE: CD
DRAWING NO.: D-8-06